



INSERT CITY OF AUSTIN NOTES HERE

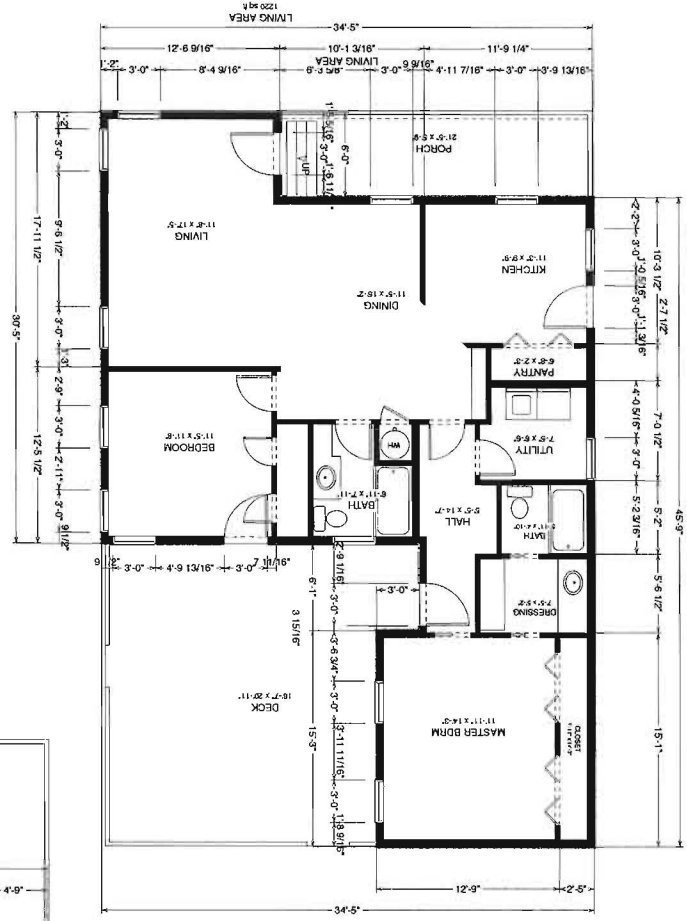

Floor Plan
1/4" = 1'

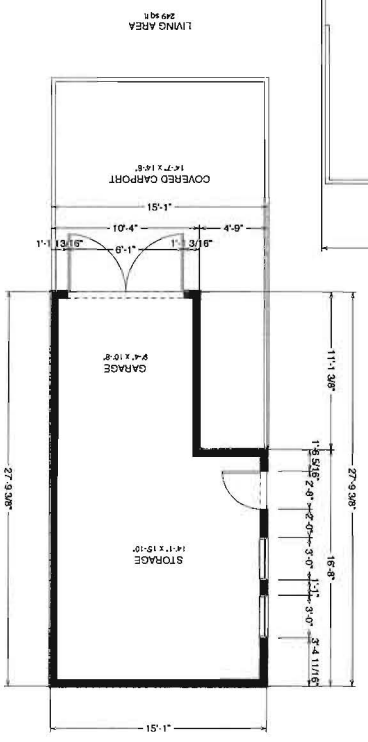

NO PART OF THIS DOCUMENT IS TO BE REPRODUCED OR TRANSMITTED IN ANY FORM OR BY ANY MEANS, ELECTRONIC OR MECHANICAL, INCLUDING PHOTOCOPYING, RECORDING, OR BY ANY INFORMATION STORAGE AND RETRIEVAL SYSTEM, WITHOUT THE WRITTEN PERMISSION OF INNOVATIVE HOME DESIGNS, INC.

© INNOVATIVE HOME DESIGNS (I.H.D.) 2007

REVISION DATE

INHD

CARTER SHACKELFORD
Innovative Home Designs
7120 Covered Bridge Dr.
Austin, TX 78736
(310) 795-3331

AS-BUILT PLANS
3103 Funston St.
Austin, TX 78703

OWNERS:
James & Jessica Stanley
3103 Funston St.
Austin, TX 78703

DESIGNER:
CDS
DATE: OCTOBER 11, 2007
SCALE: 1/4" = 1'

A-3